


**WATER PLAN
DEER VALLEY SUBDIVISION
TONTITOWN, ARKANSAS**

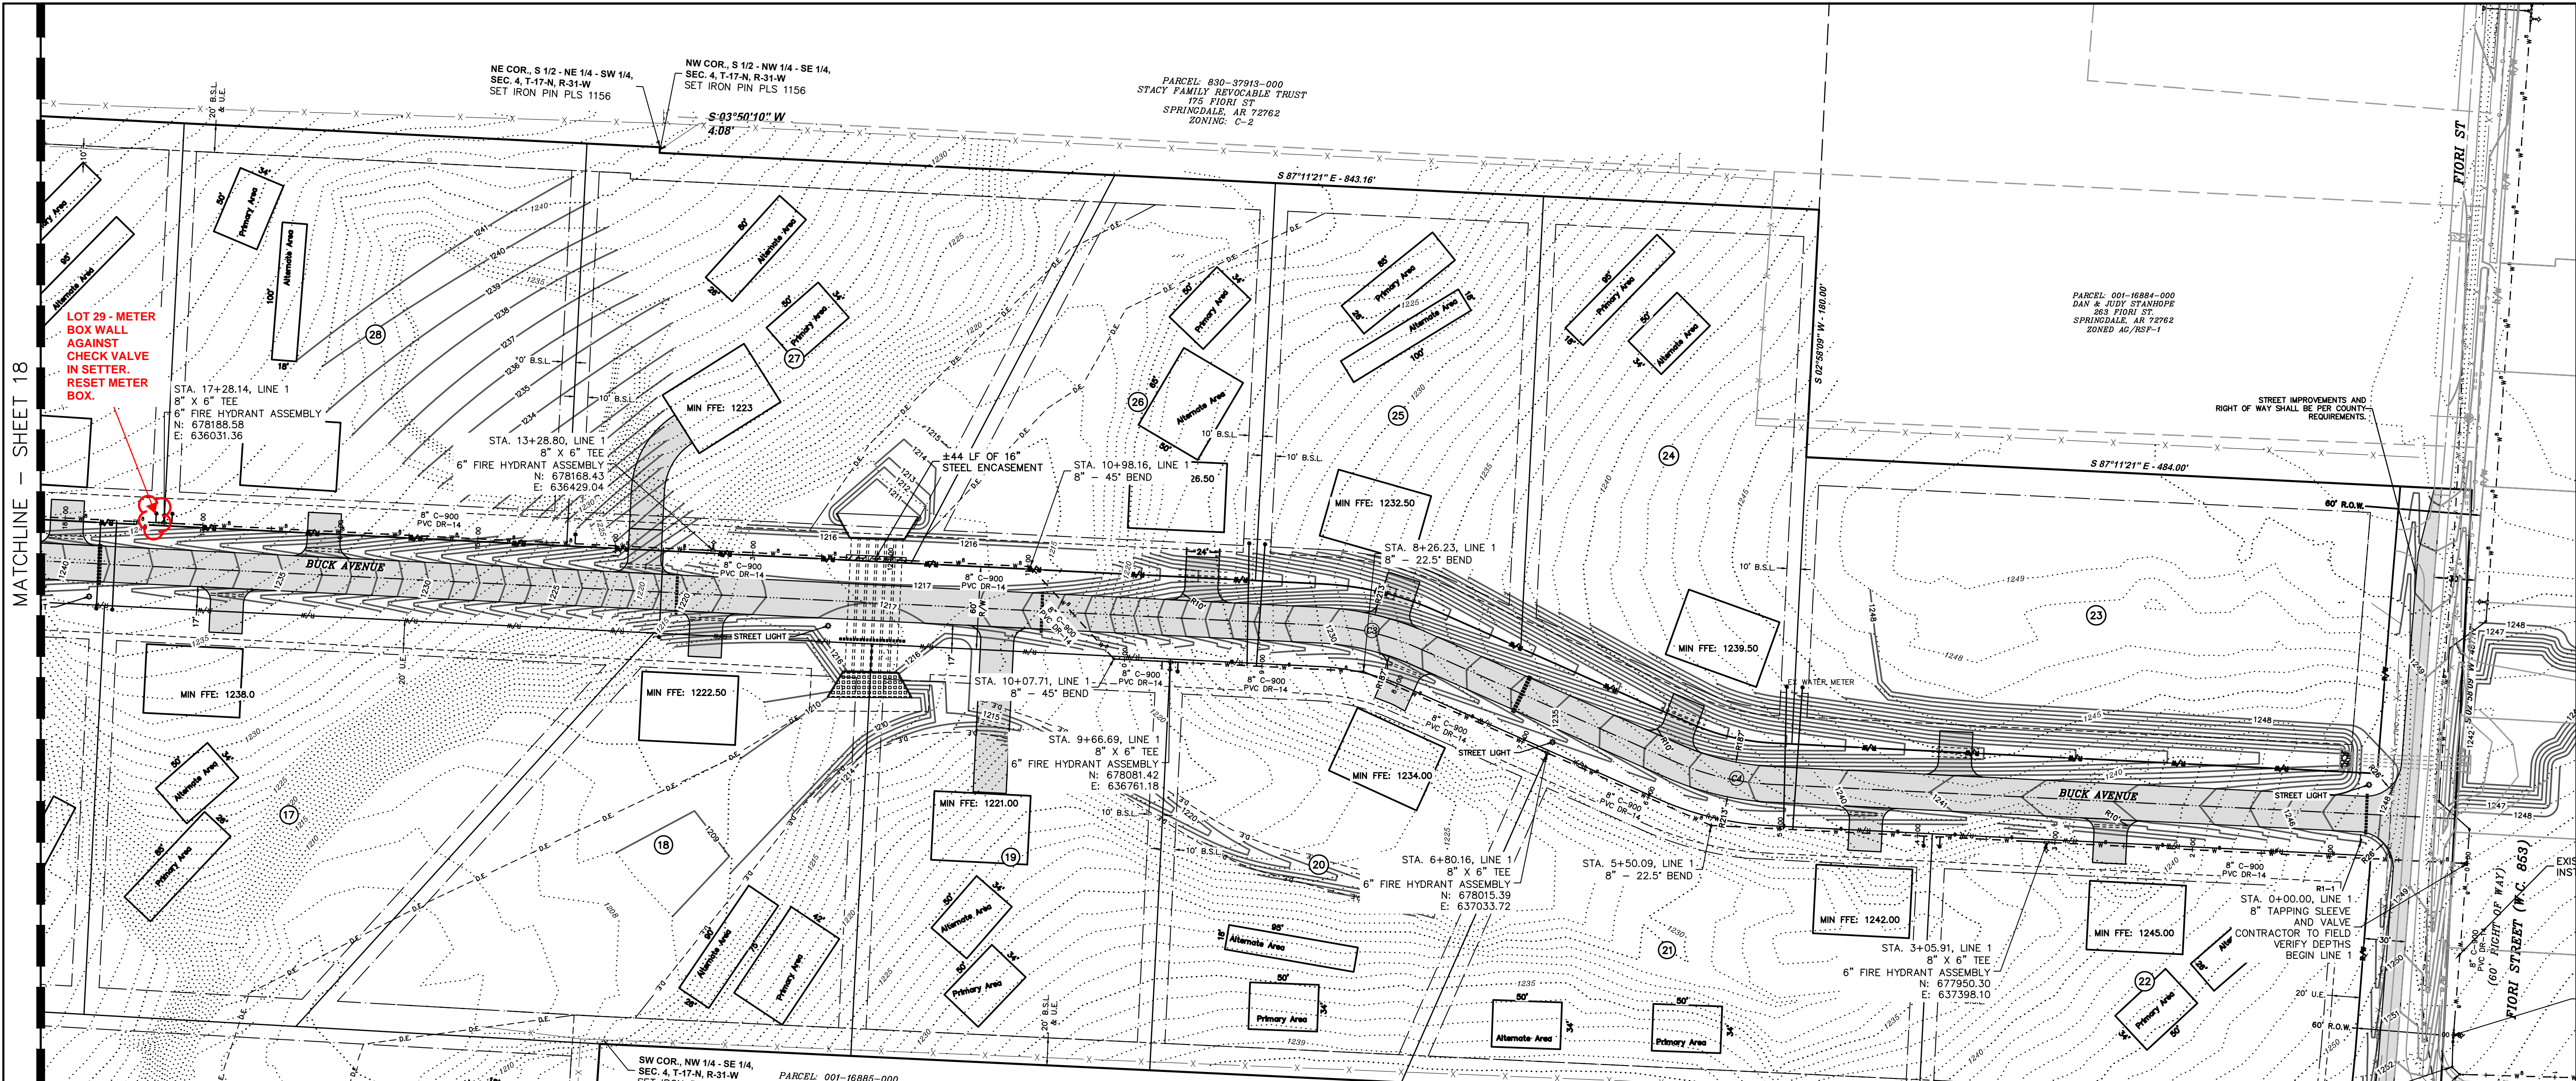



Raw Description	Elevation	Northing	Easting
WV	1232.934	676522.3980	635690.0106
WV	1232.908	676524.1607	635691.3530
FH	1232.401	676524.1988	635693.1659
WM	1233.784	676786.0195	635716.6841
WV	1232.455	676802.9492	635705.7656
WV	1232.439	676804.2578	635707.3758
FH	1232.349	676804.4726	635708.4087
FH	1205.317	677048.7052	635723.3336
WV	1205.897	677048.8337	635721.8151
WV	1205.888	677048.1006	635720.1179
WM	1200.822	677302.7393	635656.2904
WM	1201.909	677313.7321	635652.1012
WV	1205.208	677385.4317	635630.9267
WV	1205.191	677386.5129	635632.2456
FH	1204.604	677386.4583	635633.9266
FH	1222.906	677625.9932	635648.0376
WV	1223.598	677626.1221	635646.3401
WV	1223.612	677625.0814	635644.9333
WM	1233.340	677839.9833	635666.4558
WV	1238.064	677992.1684	635665.5932

Raw Description	Elevation	Northing	Easting
WV	1238.062	677993.3683	635666.7236
FH	1237.612	677993.3055	635668.8536
WM	1238.007	678123.2520	635981.8476
WM	1238.018	678122.4422	635993.3843
WM	1218.415	678102.4996	636390.5445
WV	1223.293	678083.2770	636761.1334
WV	1223.294	678084.4779	636762.1722
FH	1222.781	678081.4150	636761.1772
WM	1222.972	678078.0757	636755.5991
WM	1223.659	678077.3628	636767.1102
WV	1234.202	678018.9399	637034.3784
WV	1234.241	678017.1583	637034.9849
FH	1233.601	678015.3925	637033.7226
WM	1242.305	677951.2429	637308.9415
WM	1242.379	677950.7108	637320.6041
FH	1238.753	677950.3011	637398.0996
WV	1239.691	677952.2734	637398.4090
WV	1239.668	677953.4667	637399.5404
WM	1244.788	678065.9431	637220.9199
WM	1228.404	678169.8669	636830.5816

Raw Description	Elevation	Northing	Easting
WM	1227.626	678170.5214	636819.0591
WV	1217.972	678165.3241	636428.0114
WV	1218.062	678166.6129	636428.8182
FH	1217.650	678168.4284	636429.0381
WM	1227.271	678177.0847	636329.7431
WM	1240.153	678192.0035	636036.9687
WM	1240.514	678192.2730	636025.3275
FH	1239.766	678188.5814	636031.3565
WV	1240.125	678186.3847	636031.1459
WV	1240.150	678185.1780	636029.9133
WV	1243.609	678198.9550	635878.4461
FH	1244.740	678205.4814	635684.9532
WV	1245.151	678203.6456	635684.7937
WV	1245.112	678202.7661	635679.1516
WV	1245.212	678201.7570	635677.6977
WV	1252.457	678451.6834	635693.9921
FH	1252.043	678451.8713	635696.0847
WV	1249.713	678458.3253	636023.7981
WM	1248.795	678361.1967	635620.8357
WM	1248.265	678349.6777	635620.1122


Raw Description	Elevation	Northing	Easting
WM	1240.222	678061.5277	635603.5632
WM	1236.187	677912.2059	635595.3730
WM	1235.812	677900.6057	635594.5164
WM	1224.339	677612.5012	635576.9370
WM	1223.931	677601.0876	635576.3070
WM	1197.371	677253.5336	635572.8569
WM	1197.083	677241.9709	635574.2155
WM	1233.180	676749.9091	635638.9623
WM	1233.114	676738.1211	635638.0637
WV	1249.892	677938.2645	637701.7502
WM	1249.290	677959.5005	637706.9157
WM	1244.218	678066.6448	637209.4644
WM	1251.821	677880.5218	637702.0278
WM	1251.418	677875.8171	637701.5088
WV	1252.577	677813.0064	637694.4822
WV	1252.606	677814.2001	637695.5097
WV	1252.555	677816.1108	637694.6115
FH	1252.402	677814.4128	637698.1007
FH	1263.481	677761.9168	638224.6096
WV	1263.707	677760.1577	638224.6719

Raw Description	Elevation	Northing	Easting
WV	1263.832	677759.0269	638223.4101
WV	1263.936	677758.6095	638225.4445
WV	1263.969	677757.0388	638226.6494
WV	1264.006	677758.5046	638228.1050
WV	1251.802	678467.3231	635693.4406

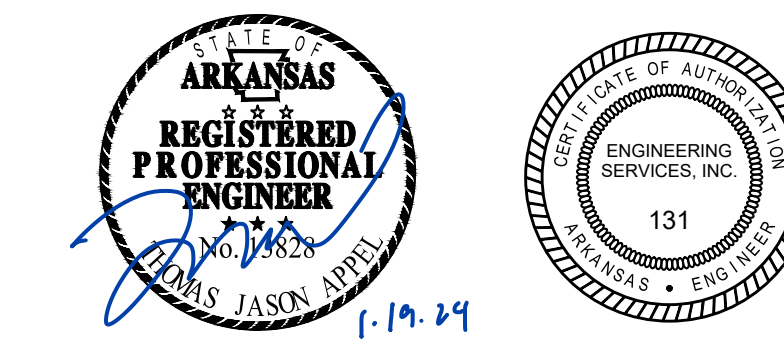
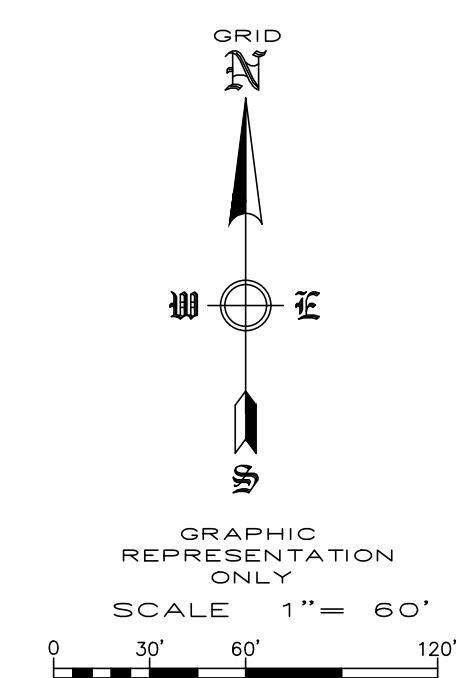


REVISION	DATE	DESCRIPTION

SCALE: 1"=60'
DATE: Jan 18, 2024
DRAWN BY: JBA
W.O. #: BAP

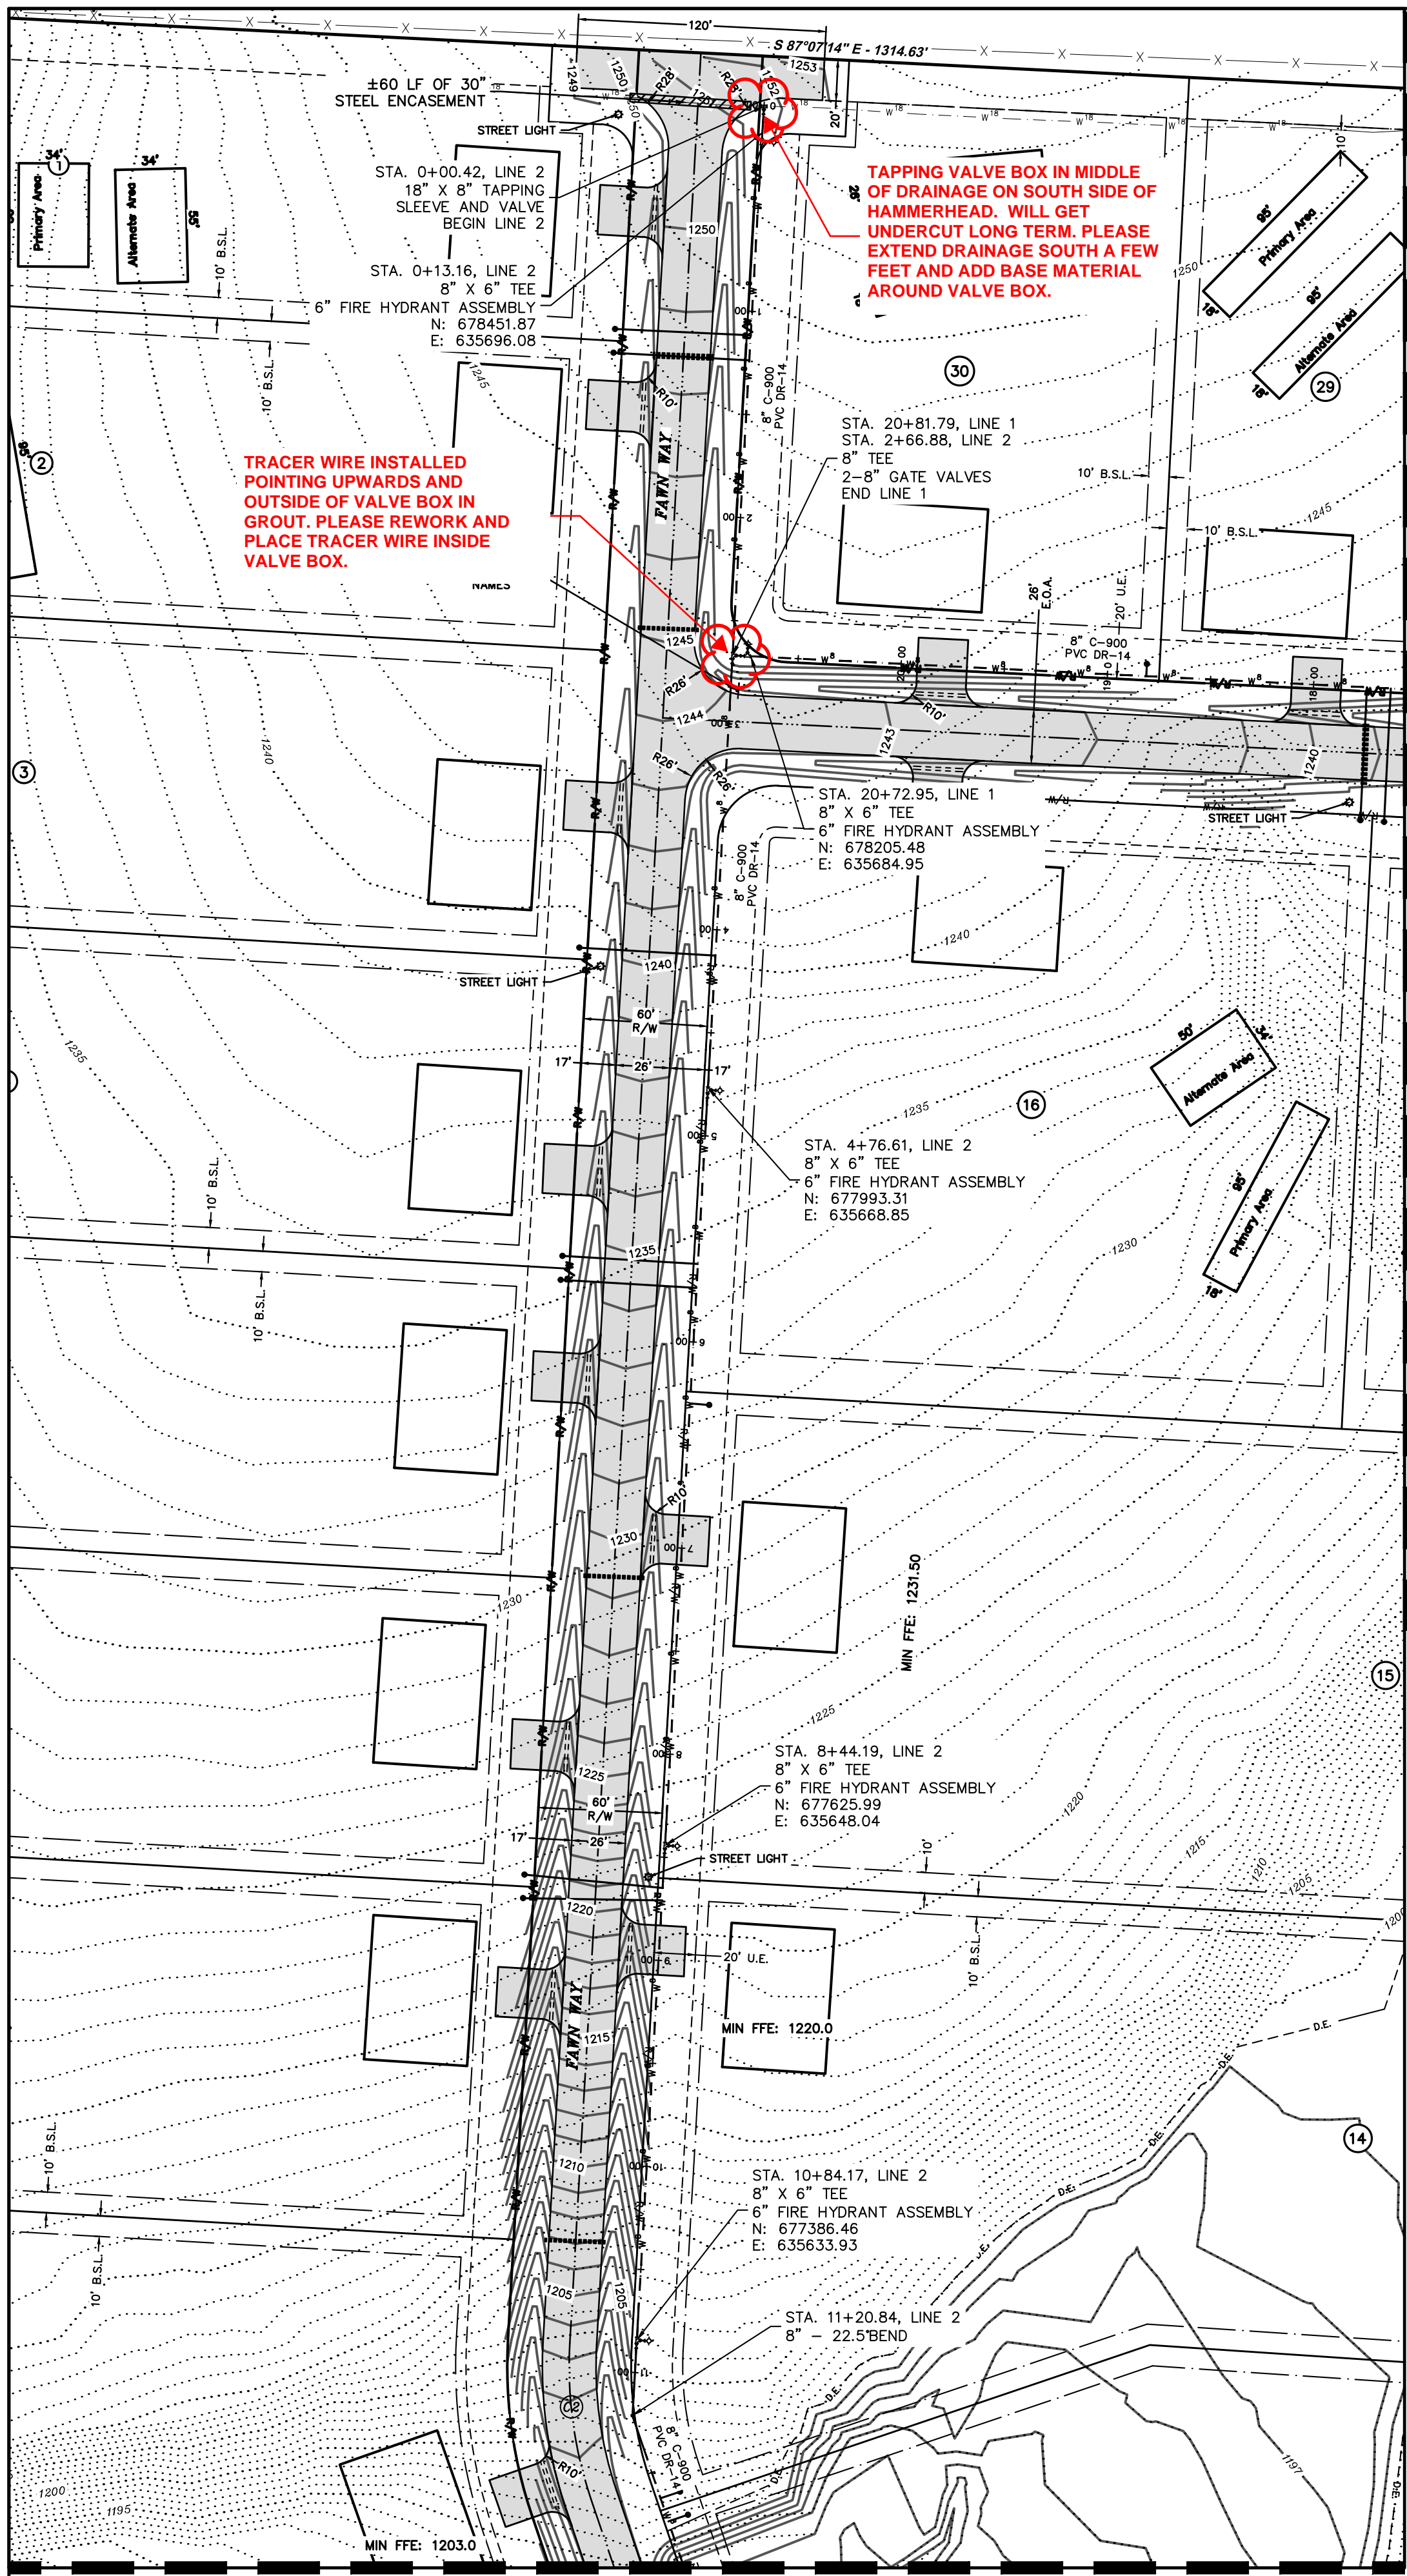


MATCHLINE - SHEET 17

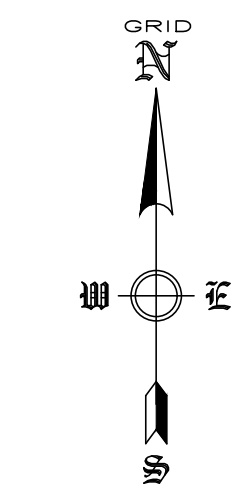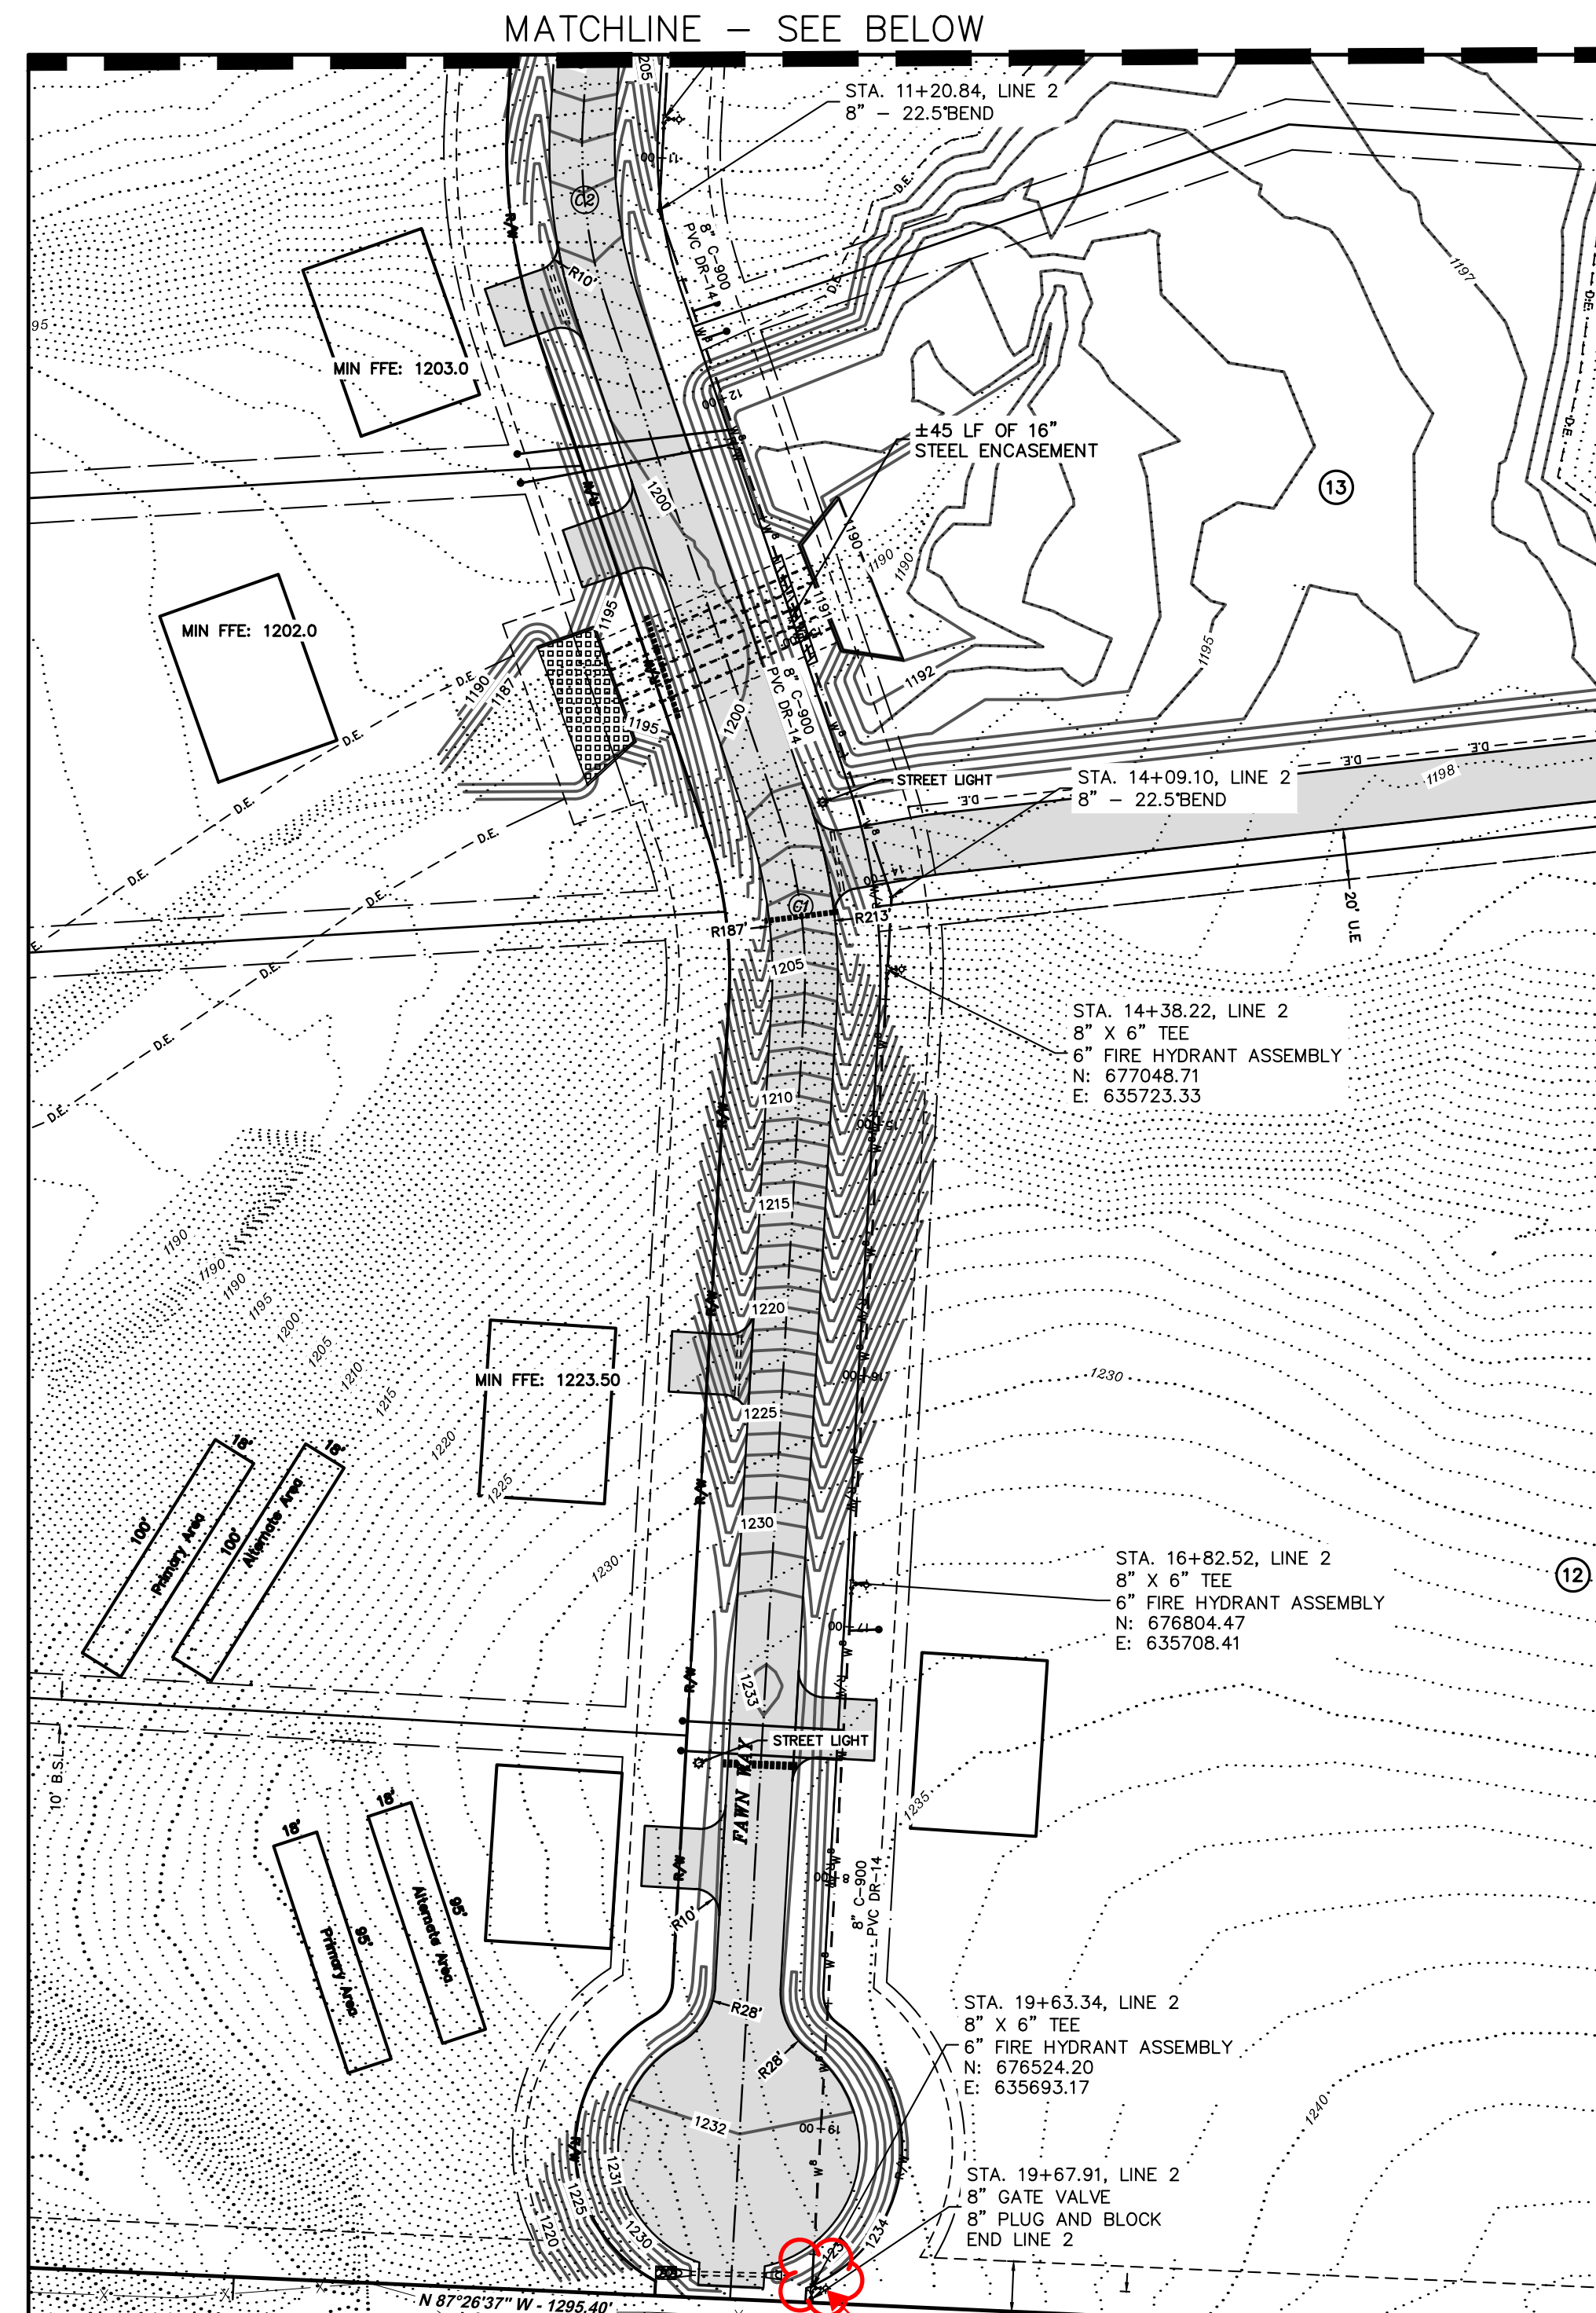

GRAPHIC REPRESENTATION ONLY
SCALE 1" = 60'



1-17-24

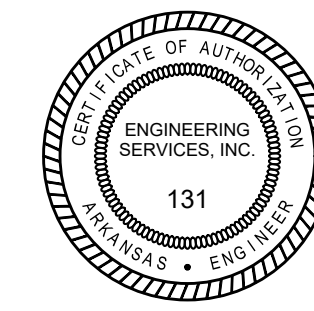



AS BUILT



WATER PLAN
DEER VALLEY SUBDIVISION
TONTITOWN, ARKANSAS

REVISION	DATE	DESCRIPTION
A	18/10/23	STREET AND WATER MAIN REVISION

SCALE: 1"=60'
DATE: Jan 18, 2024
ENGINEER: JIA
DRAWN BY: BAP
W.O. #:

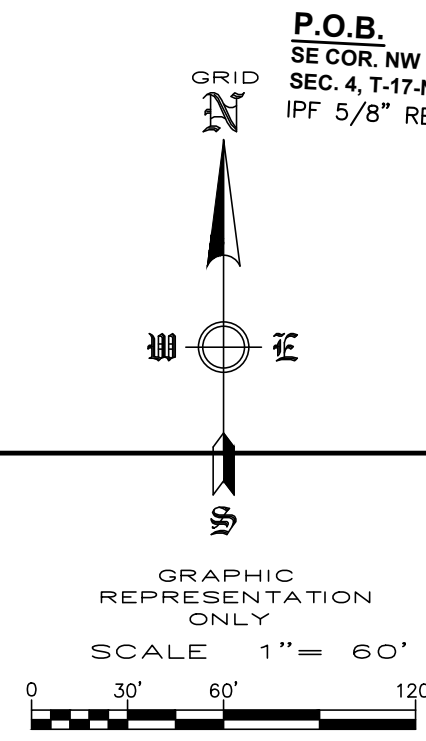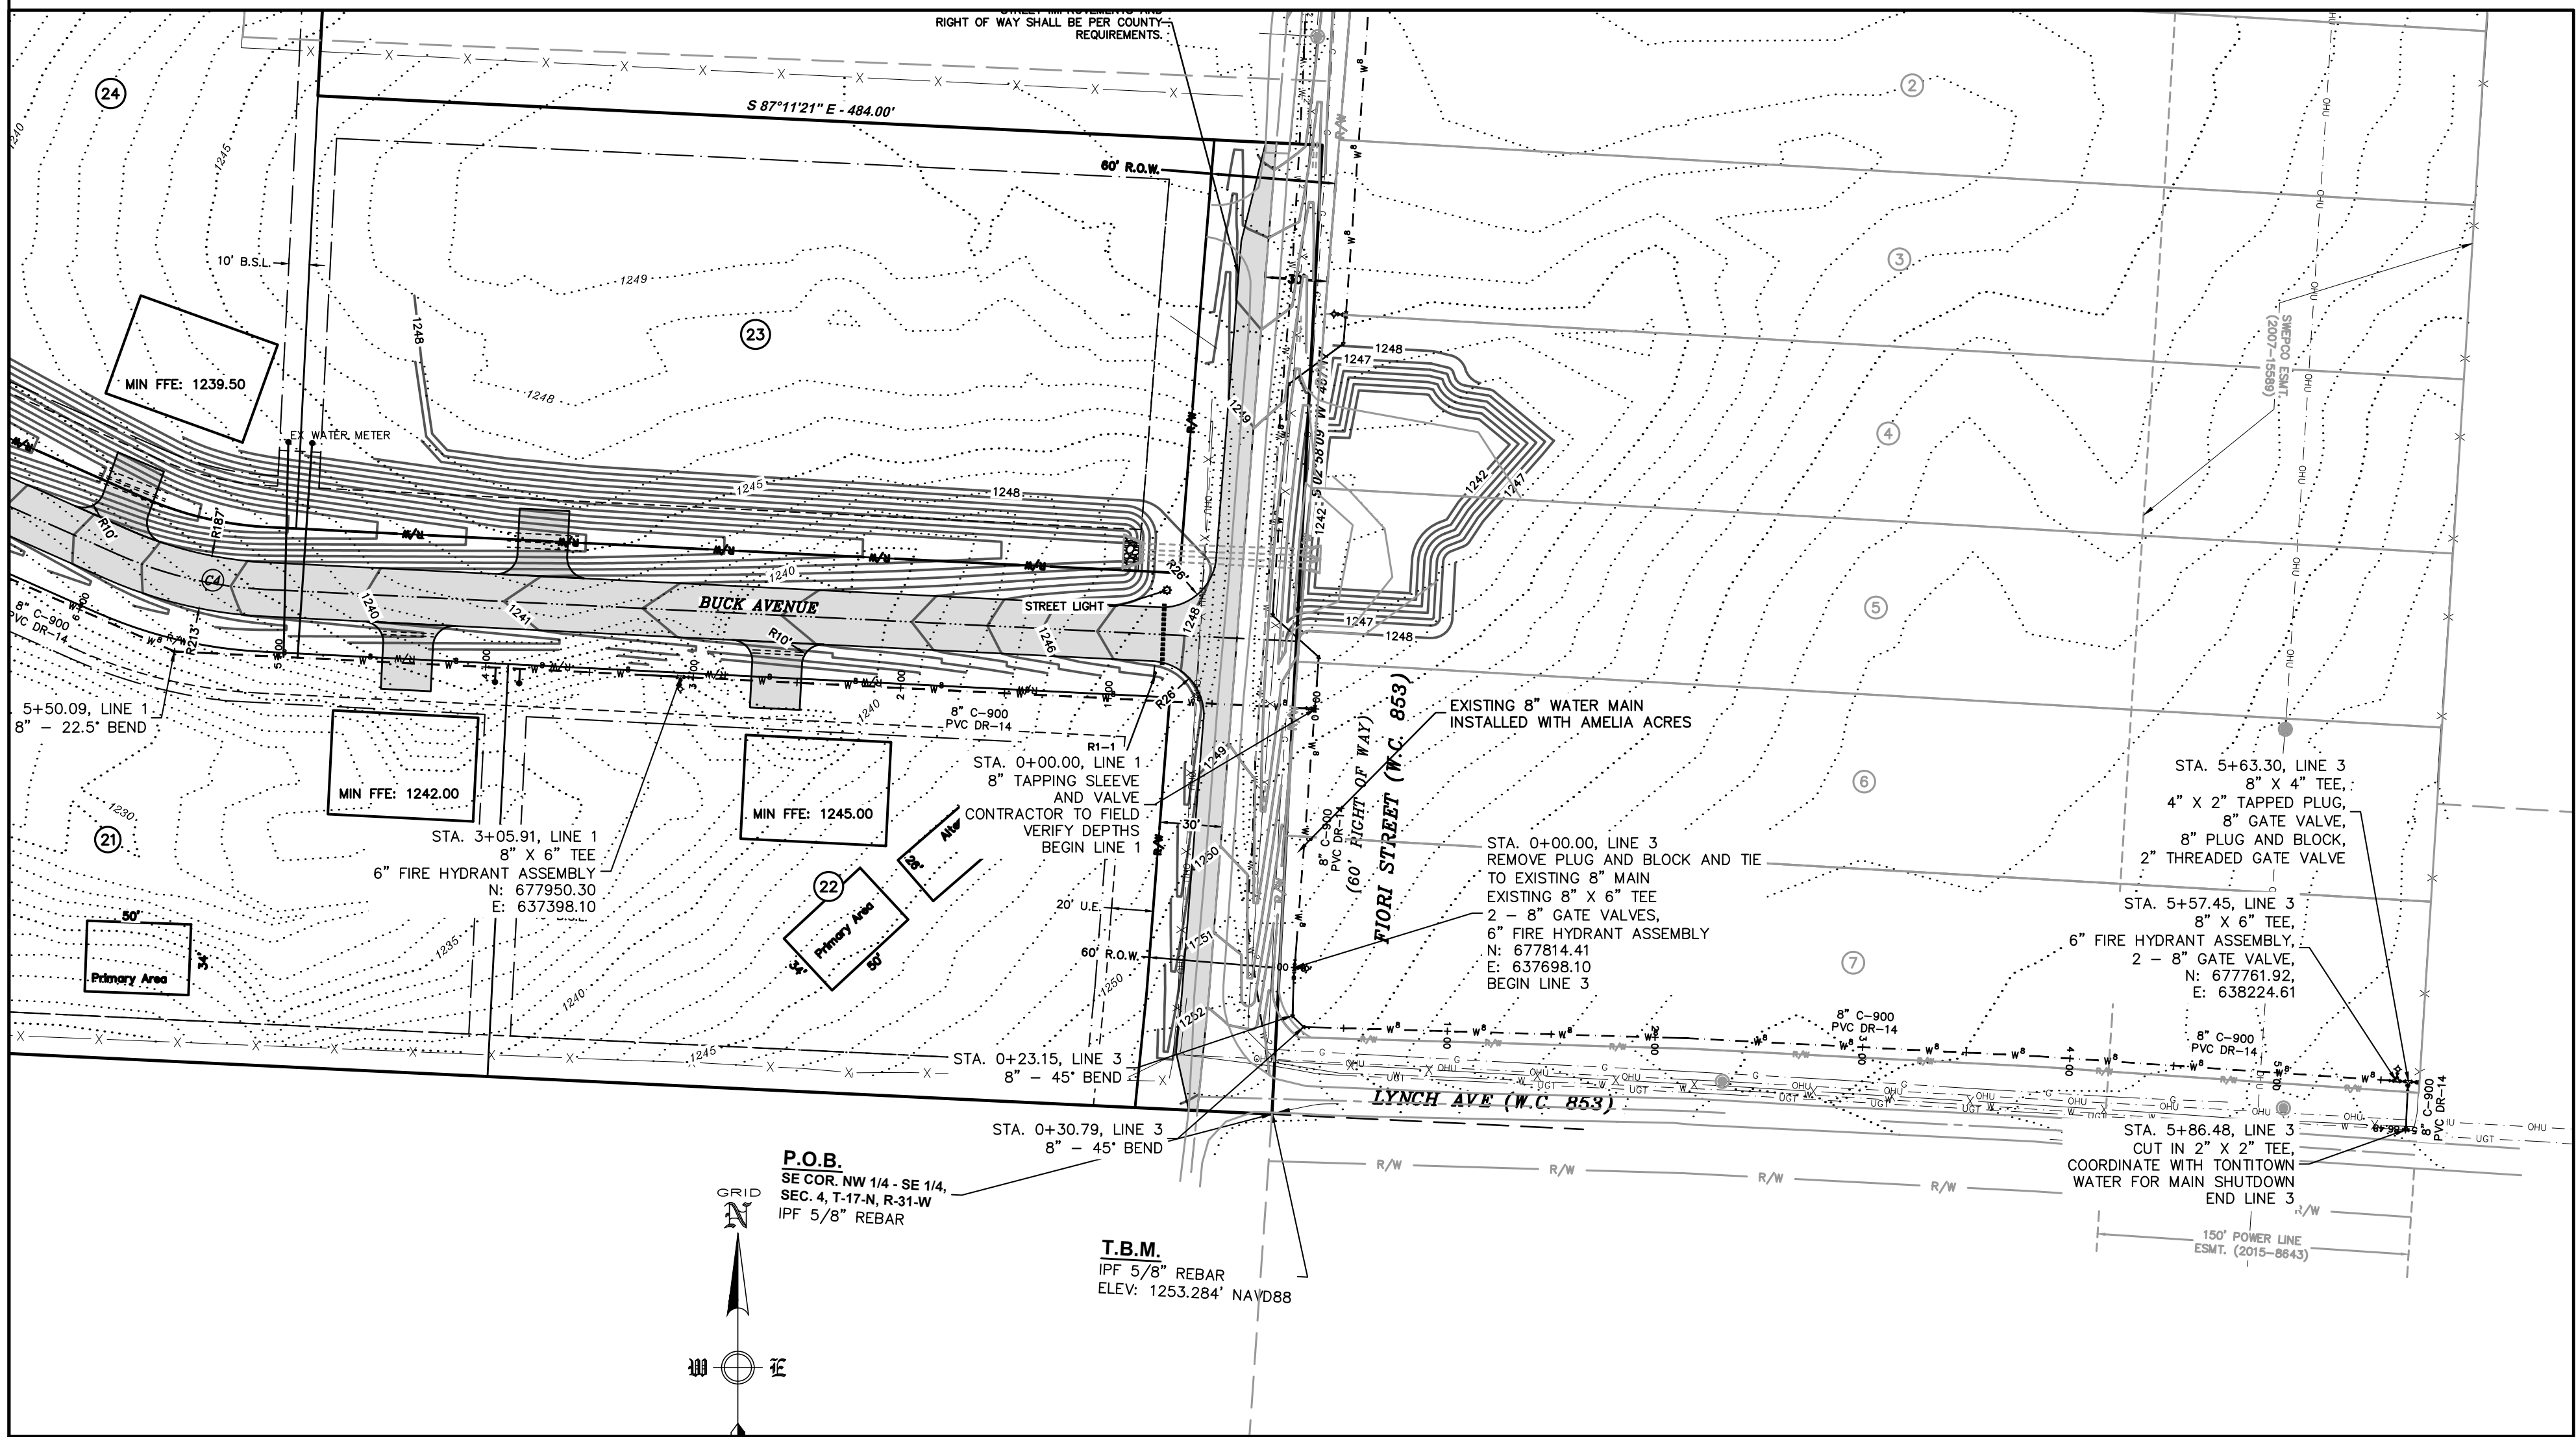

P.O.B.
SE COR. NW 1/4, SE 1/4,
SEC. 4, T-17-N, R-31-W
IPF 5/8" REBAR

T.B.M.
IPF 5/8" REBAR
ELEV: 1253.284' NAVD88



**OFFSITE WATER MAIN EXTENSION
DEER VALLEY SUBDIVISION
TONTITOWN, ARKANSAS**

REVISION	DATE	DESCRIPTION

SCALE: 1"=60'
DATE: Jan 18, 2024
ENGINEER: JJA
DRAWN BY: BAP
W.O. #:



AS BUILT